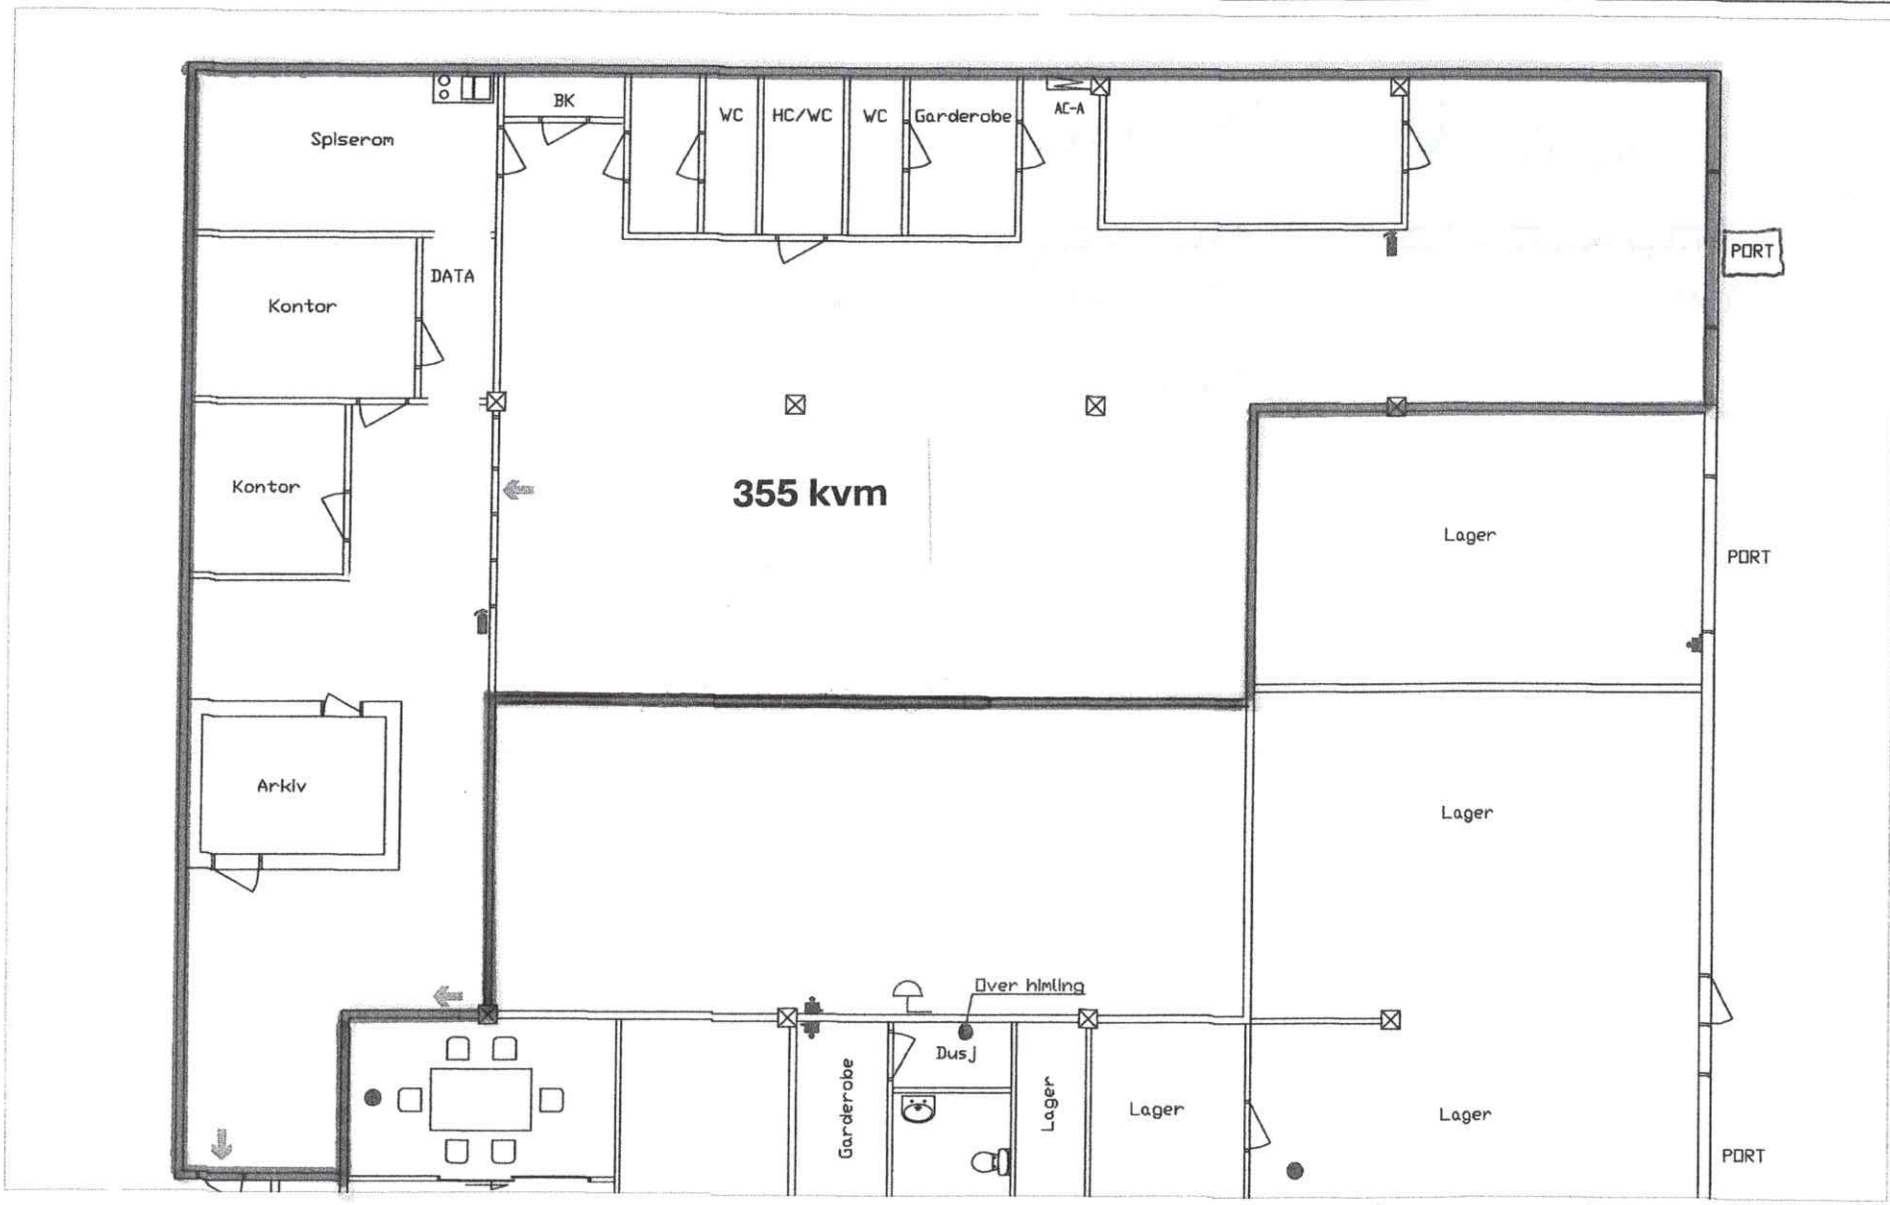

AS BUILT

Steinfjor Handelspark AS

Coop

1 etasje

Sparebu PA & Consulting AS
Prosjekt
7718 Sparbu
Tlf. 971 16 027
Fax

02